


Curve Table - F.O.C.							
#	R (m)	L (m)	Delta (Δ)	BC Northing	BC Easting	EC Northing	EC Easting
C100	144.800	10.816	4.271°	5935753.454	57507.221	5935764.264	57507.463
C101	20.000	10.481	30.027°	5935764.264	57507.463	5935774.415	57505.382
C102	14.000	24.358	99.685°	5935774.415	57505.382	5935794.078	57513.825
C103	14.000	43.009	176.018°	5935796.126	57520.558	5935769.653	57529.627
C104	20.000	24.419	69.956°	5935769.653	57529.627	5935750.670	57516.764
C105	2.000	3.904	111.995°	5935773.338	57518.305	5935774.273	57515.127
C106	29.000	4.509	8.909°	5935774.273	57515.127	5935778.445	57513.429
C107	5.000	8.699	99.685°	5935778.445	57513.429	5935785.468	57516.444
C108	5.000	15.361	176.018°	5935787.516	57523.177	5935778.061	57526.416
C109	29.000	9.427	18.625°	5935778.061	57526.416	5935773.338	57518.305
C110	93.800	54.411	33.236°	5935864.604	57465.735	5935880.747	57516.900
C111	84.300	48.900	33.236°	5935874.103	57465.587	5935888.611	57511.570

- TRAFFIC SIGNS**
- ① CONSTRUCTION ACCESS ONLY

SIGNAGE TABLE OF MATERIALS

ITEM	TYPE	NUMBER
WA-8	CHECKERBOARD - DEAD END	1
RB-51R	PARKING PROHIBITED (RIGHT)	2
RB-51L	PARKING PROHIBITED (LEFT)	2
RB-51	PARKING PROHIBITED	2
RB-53	PARKING PERMITTED	2
RB-25	KEEP RIGHT	1
WA-36-L	HAZARD MARKER - OBJECT ON LEFT	1
T-1	TRAIL - STOP	2

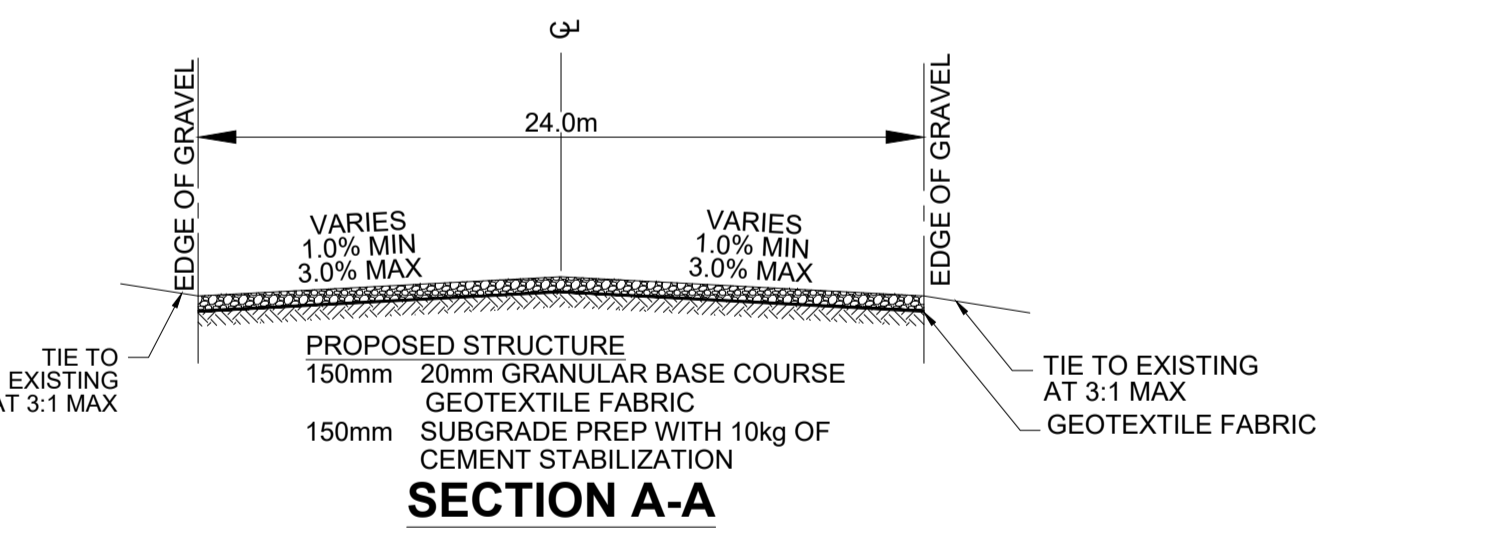

NOTE

- ELECTRICAL FURNITURE LOCATIONS SHOWN ARE BASED ON THE 'APPROVED FOR CONSTRUCTION' DRAWINGS SET FROM DES ENGINEERING, SHAW / ROGERS, AND ATCO GAS.
- ANY RELOCATION OF ELECTRICAL FURNITURE REQUIRED DURING CONSTRUCTION IS TO BE APPROVED BY STRATHCONA COUNTY PRIOR TO BEING COMPLETED ONSITE.

NOTES

- NO DRIVEWAYS PERMITTED WITHIN 1.5m OF STREET FURNITURE.
- APPROVED DRIVEWAY LOCATIONS ARE SHOWN. NO DEVIATION PERMITTED WITHOUT PRIOR APPROVAL OF THE COUNTY ENGINEER.
- CURB TRANSITION FROM ROLLED FACE TO STRAIGHT FACE ARE SHOWN THUS: SF → RF

ROADWAY STRUCTURES

EXISTING	PROPOSED	EXISTING	PROPOSED
LOCAL ROADWAYS 40mm 10mm-LT ASPHALT 75mm 10mm-LT ASPHALT 200mm 20mm GRANULAR BASE COURSE 150mm SUBGRADE PREP WITH 10kg OF CEMENT STABILIZATION	HEAVY DUTY ASPHALT TRAIL 100mm 10mm-LT (2 LIFTS) 150mm 20mm GBC 150mm SUBGRADE PREP WITH 10kg OF CEMENT STABILIZATION	EXISTING CLAY CONSTRUCTION ACCESS 150mm SUBGRADE PREP COMPACTED TO 100% SPD.	TEMPORARY GRAVEL TURNAROUND 150mm 20mm GRANULAR BASE COURSE GEOTEXTILE FABRIC 150mm SUBGRADE PREP WITH 10kg OF CEMENT STABILIZATION

LINEPAINTING & PAVEMENT MARKINGS

- TO STRATHCONA COUNTY STANDARDS
- ALL STREET MARKINGS TO BE PAINTED AT CCC
 - ALL STREET MARKINGS ARE TO BE PF TYPE INLAY THERMOPLASTIC AT FAC
 - ② SOLID YELLOW CENTERLINE 0.075m WIDE
 - ③ SOLID YELLOW STOP LINE 0.250m WIDE

FENCING

- SEE LANDSCAPING DRAWINGS (666-033-226.01, 666-033-226.02, 666-033-226.03) FOR FENCING LOCATIONS AND DETAILS.

THIS DRAWING INDICATES REDLINE RECORD INFORMATION

<p>EXISTING</p> <p>PROPERTY LINE RIGHT OF WAY LINE CURB AND GUTTER MONOLITHIC WALK ASPHALT TRAIL</p> <p>STREET ADDRESS STREET SIGNS</p>	<p>LEGEND</p> <p>PROPOSED</p> <p>FUTURE</p>	<p>EXISTING</p> <p>VALVE HYDRANT MANHOLE CATCH STOP CATCH BASIN TRANSFORMER LIGHT STANDARD MAILBOX T-BOLLARDS</p>	<p>PROPOSED</p> <p>VALVE HYDRANT MANHOLE CATCH STOP CATCH BASIN TRANSFORMER LIGHT STANDARD MAILBOX T-BOLLARDS</p>	<p>EXISTING</p> <p>DIRECTION OF DRAINAGE DRIVEWAY LOCATION WATER, SANITARY & STORM SERVICE LOCATIONS</p>	<p>PROPOSED</p> <p>DIRECTION OF DRAINAGE DRIVEWAY LOCATION WATER, SANITARY & STORM SERVICE LOCATIONS</p>	<table border="1"> <tr><td>7.</td><td>ISSUED TO SUPPORT BUILDING PERMITS</td><td>AUG 23/24</td><td>NAS</td></tr> <tr><td>6.</td><td>UPDATED FURNITURE & ADDRESS INFORMATION</td><td>AUG 23/24</td><td>NAS</td></tr> <tr><td>5.</td><td>3rd SUBMISSION FOR COUNTY APPROVAL</td><td>DEC 22/23</td><td>NAS</td></tr> <tr><td>4.</td><td>REVISED PER 2nd SUBMISSION COMMENTS</td><td>DEC 12/23</td><td>DML</td></tr> <tr><td>3.</td><td>2nd SUBMISSION FOR COUNTY APPROVAL</td><td>AUG 04/23</td><td>NAS</td></tr> <tr><td>2.</td><td>REVISED PER COUNTY COMMENTS</td><td>JUL 27/23</td><td>NAS</td></tr> <tr><td>1.</td><td>1st SUBMISSION FOR COUNTY/CLIENT REVIEW</td><td>FEB 07/23</td><td>NAS</td></tr> </table>	7.	ISSUED TO SUPPORT BUILDING PERMITS	AUG 23/24	NAS	6.	UPDATED FURNITURE & ADDRESS INFORMATION	AUG 23/24	NAS	5.	3rd SUBMISSION FOR COUNTY APPROVAL	DEC 22/23	NAS	4.	REVISED PER 2nd SUBMISSION COMMENTS	DEC 12/23	DML	3.	2nd SUBMISSION FOR COUNTY APPROVAL	AUG 04/23	NAS	2.	REVISED PER COUNTY COMMENTS	JUL 27/23	NAS	1.	1st SUBMISSION FOR COUNTY/CLIENT REVIEW	FEB 07/23	NAS	<p>DESIGN: NAS CHECKED: NAS JOB NO: 666-033</p> <p>DRAWN BY: DML APPROVED: KBA DRAWING NO:</p> <p>SCALE: 1:750 DATE: JANUARY 2023 666-033-207&221</p>	<p>ARDROSSAN STAGE 10A BY ARDROSSAN EAST LTD. IN STRATHCONA COUNTY</p>
7.	ISSUED TO SUPPORT BUILDING PERMITS	AUG 23/24	NAS																																	
6.	UPDATED FURNITURE & ADDRESS INFORMATION	AUG 23/24	NAS																																	
5.	3rd SUBMISSION FOR COUNTY APPROVAL	DEC 22/23	NAS																																	
4.	REVISED PER 2nd SUBMISSION COMMENTS	DEC 12/23	DML																																	
3.	2nd SUBMISSION FOR COUNTY APPROVAL	AUG 04/23	NAS																																	
2.	REVISED PER COUNTY COMMENTS	JUL 27/23	NAS																																	
1.	1st SUBMISSION FOR COUNTY/CLIENT REVIEW	FEB 07/23	NAS																																	